



ARCHITECTURAL RESOURCES GROUP
Architects, Planners & Conservators, Inc.
San Francisco, California
415-441-1880 fax 415-441-0277

NO.	DESCRIPTION	DATE
REVISIONS		


KENNEY COTTAGE
HISTORIC AND EXISTING CONDITIONS
1719 UNIVERSITY AVENUE
BERKELEY, CALIFORNIA

SHEET TITLE
EXISTING CONDITIONS PLAN

ISSUANCE
100% DOCUMENTATION DRAWINGS
DATE
June 20, 2002


PROJ. NO.
02063
DRAWN
J.B./J.C.
CHECKED
J.J./J.C.

DRAWING NO.
A2.1
SHEET 2 OF 4

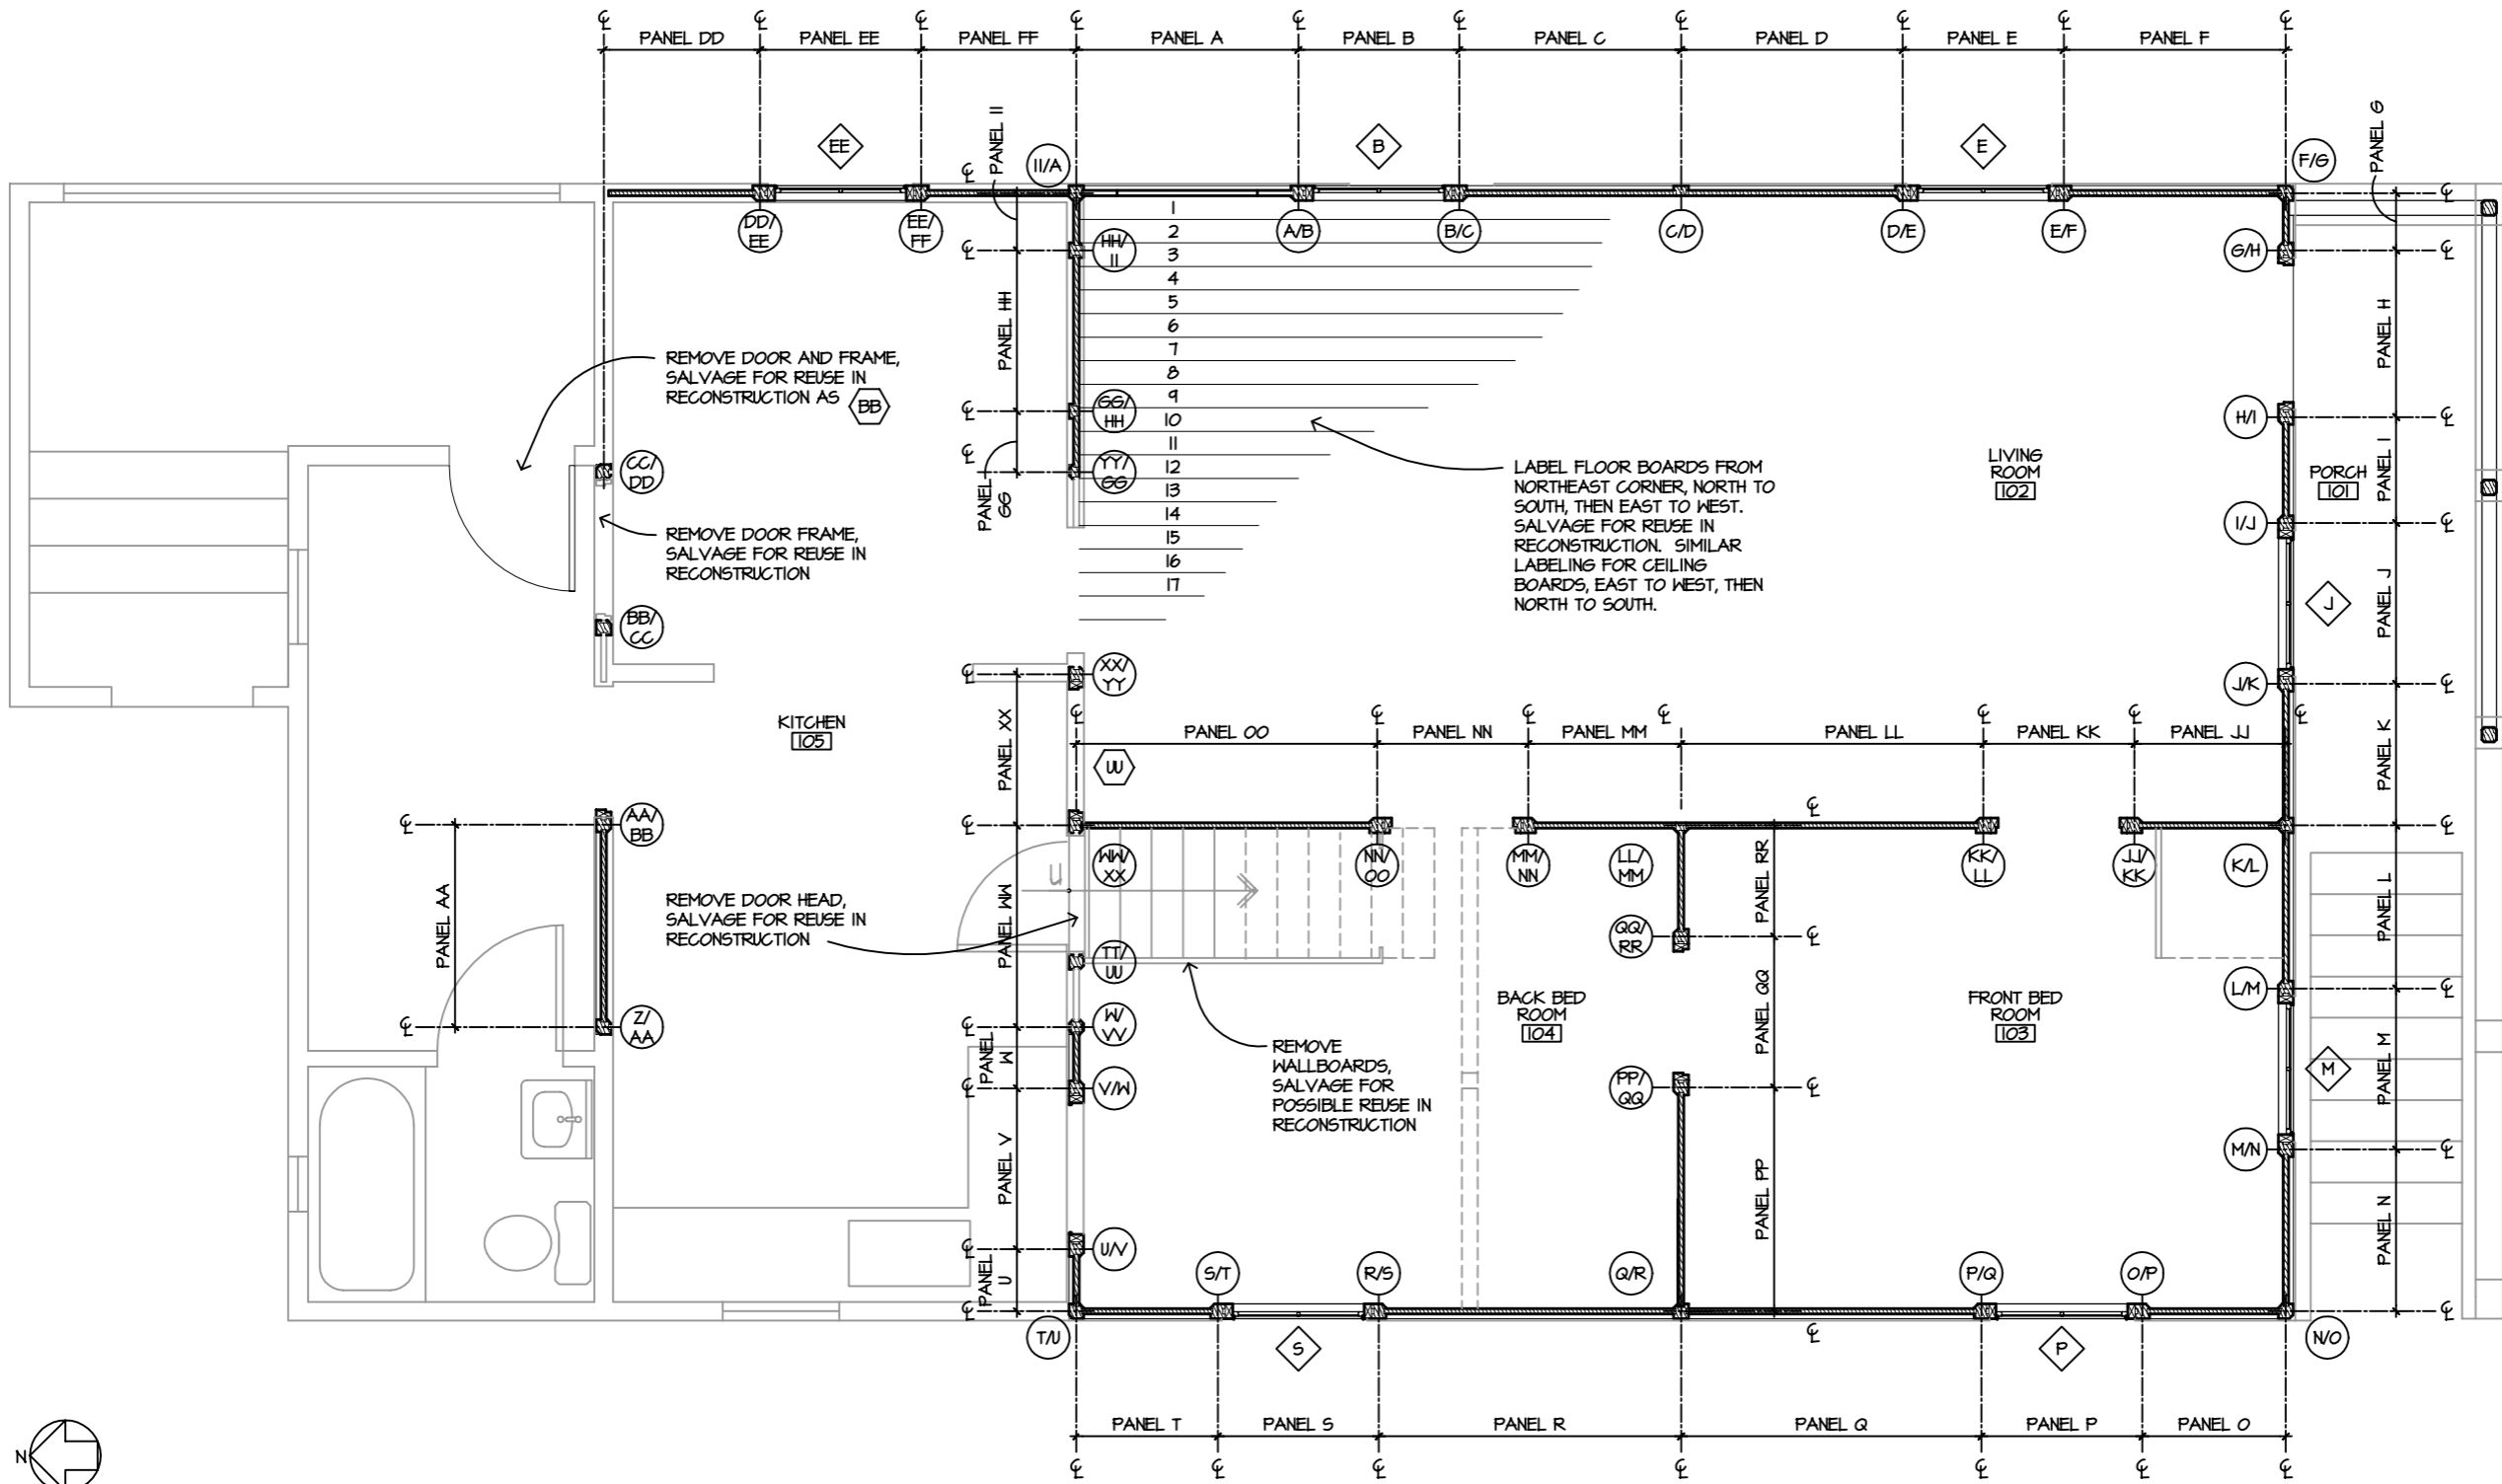

EXISTING CONDITIONS FLOOR PLAN
SCALE: 1/2" = 1'-0"
AS-BUILT FLOOR PLANS

- NOTES**
- ALL NON-HISTORIC BUILDING AND FINISH MATERIALS (THOSE ADDED SINCE CONSTRUCTION IN 1887) TO BE REMOVED. HISTORIC BUILDING MATERIALS TO BE LABELED AS NOTED ON DRAWINGS AND STORED FOR RECONSTRUCTION. HISTORIC BUILDING MATERIALS SHOWN IN BOLD.
 - (E) DOORS CURRENTLY STORED IN ATTIC TO BE SALVAGED FOR REUSE IN RECONSTRUCTION.
 - SALVAGE HISTORIC POST IN ATTIC ABOVE KITCHEN.
 - SALVAGE ALL HISTORIC WALL BOARD FOR POSSIBLE REUSE.

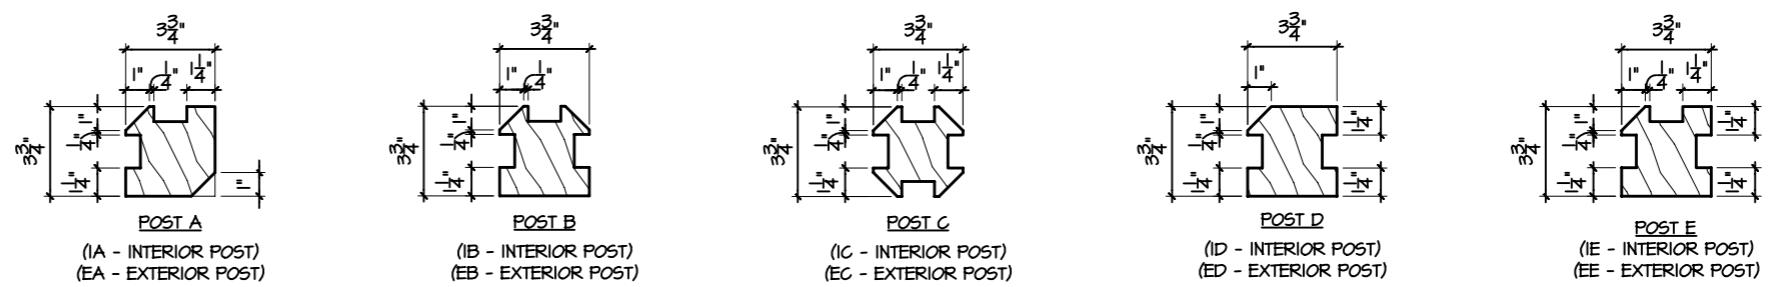

© ARCHITECTURAL RESOURCES GROUP